


# 3300 IRVINE


SUITE 210 | 1,335 RSF

**AS-BUILT**

**2ND FLOOR**

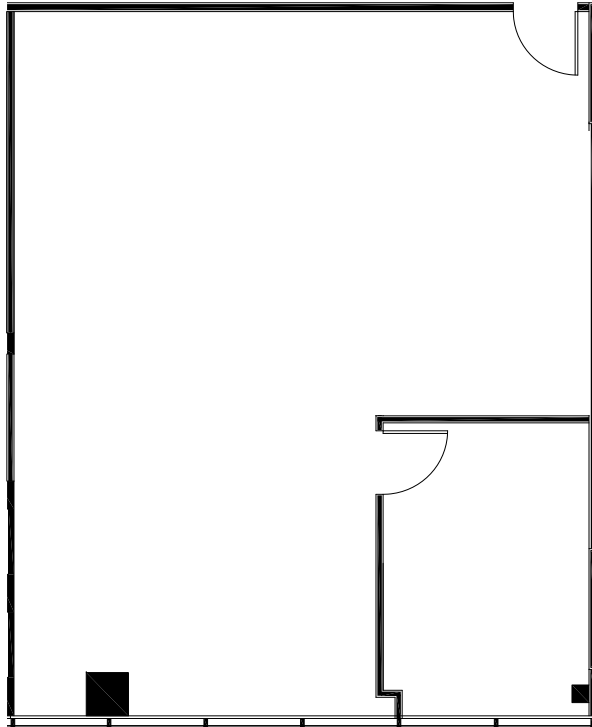

**HYPOTHETICAL**

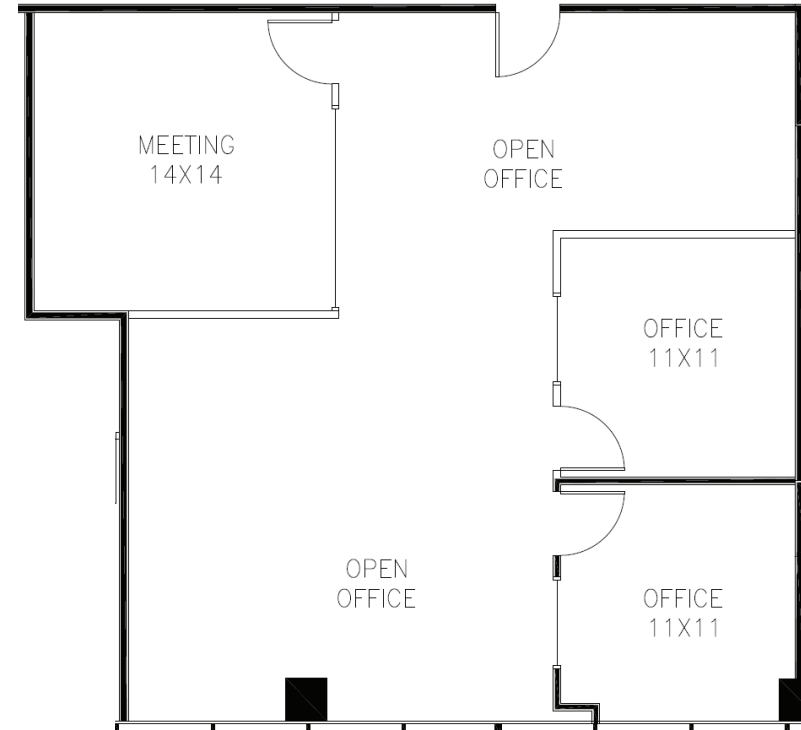

**FOR LEASING INFORMATION,  
CONTACT A STREET PARTNERS AT 949 381 5100  
OR VISIT [ASTREETPARTNERS.COM](http://ASTREETPARTNERS.COM)**

**BLAINE  
ANNETT** PARTNER

blaine@astreetpartners.com  
License No. **01861733**

**COLBY  
ANNETT** PARTNER

colby@astreetpartners.com  
License No. **01859824**

**MORGAN  
LIEBER** SENIOR ASSOCIATE

morgan@astreetpartners.com  
License No. **01967995**